

(21)

DL#274387

50'-2	45'-2
9' DXD (23D)	---
3ø TP ASSEMBLY (23D)	---
3-25K FUSE	---
2-BKCN	---
---	2-SEC DE CLAMP
---	1-LG AE CLAMP
---	1-18M LG (AE)
-SET NEW POLE 15' FROM EXISTING POLE	
-REMOVAL OF EXISTING POLE TO BE DONE AFTER ENERGIZATION OF NEW PWSA MAINPENTER SERVICE	
ON WO#761379	
-TRANSFER CITY ST. LT TO NEW POLE	

CITY OF PITTSBURGH
82-H-1-0-2

DL#20257	
40'-5	50'-2
1-PTE	---
8' SX (23D)	9' DXD (23D)
	(OH-7-20-A)
1-37KVA BØ XMFR (23D)	1-37KVA BØ XFMR (23D)
	(OH-10-44)
1-BK358	---
1-BKCN	---
	2-SEC DE CLAMP

	1-LG AE CLAMP
1-10M LG (SEC)	---

SUMMARY				
DLC WORK	QTY	PRIVATE PROPERTY	QTY	MUNICIPALITY
INSTALL POLE	0		2	(17) (22)
INSTALL ANCHOR	1	(17)	1	(22)
REPLACE POLE	0		4	(15) (19) (20) (21)
REPLACE ANCHOR	0		1	(15)

NOTE 1: - ATTACH MESSENGER & COMMON NEUTRAL
TO GROUND WIRE (OH-14-2-F)
NOTE 2: - ATTACH CABLE SHIELD TO MESSENGER
(OH-14-4-B) OR (OH-14-4-C)
NOTE 3: - INSTALL COMMON NEUTRAL ABOVE AERIAL
CABLE
NOTE 4: - INSTALL AERIAL CABLE CLAMP TO PROVIDE
2' MINIMUM CLEARANCE TO NEWLY
INSTALLED COMMON NEUTRAL.

*** CITY OF PITTSBURGH**
82-G-50

(22)
DL#157748

---	40'-3
---	1-DBL. HLX ANC.
---	1-10M ANC. GUY

- TRANSFER EXISTING SIGN TO POLE
- CITY TO INSTALL ST. LT.

DL#157748	
45'-2	50'-2
8' SX (23D)	8' SX (23D)
	(OH-7-27-C)
1-37KVA AØ XFMR (23D)	1-37KVA AØ XFMR (23D)
	(OH-10-44)
3-BK358	---
---	2-SEC DE CLAMP
---	1-LG AE CLAMP
-XFER ST LT IN LIEU OF PERMIT	

DL#476061

---	50'-2
---	8' SX (23D) (OH-7-27-C)
---	1-SM SEC CLAMP
---	2-AE DE CLAMP
---	AE MESSENGER GND (NOTE 1)
---	2-DBL. HLX ANC.
---	2-18M ANC. GUY (AE)



 FINAL DESIGN PA ONECALL
 SERIAL NUMBERS
 20242753788

DE CLAMP
 E CLAMP


(16)
 DL# 408601

1-BK358	1-BK358
---	1-SEC. DE CLAMP
3-SEC ISOLATING CONNECTOR	1-SEC. DE CLAMP


(15)
DL#426607

(NOTE 1) 45'-2 9' DXDD (23D) 1-BKCN 1-BK358 1-DBL. HLX ANC. 1-10M ANC. GUY (23D)	50'-2 9' DXDD (23D) (OH-7-20) 1-BKCN 1-SEC. DE CLAMP 1-LG AE CLAMP 1-DBL. HLX ANC. 1-10M ANC. GUY (23D)
--	--

DLC CANNOT MOVE POLE TO EDGE OF R/W
DUE TO SEVERE IMPACT ON LINE ANGLE

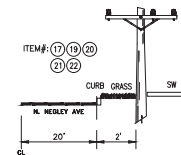

DLC CANNOT MOVE POLE TO EDGE OF R/W
DUE TO SEVERE IMPACT ON LINE ANGLE

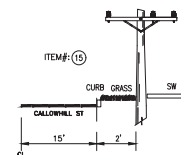

RELATED DRAWINGS

761379-T1	~ OH CONSTRUCTION DRAWING 1
761379-T2	~ OH CONSTRUCTION DRAWING 2
761379-T3	~ UG CONSTRUCTION DRAWING
761379-T4	~ CABLE PULL DRAWING
761379-T5	~ D23825 REMOVALS
761379-T6	~ CIRCUIT MAP REVISION
761379-T7	~ EQUIPMENT GROUNDING DETAILS
761379-T8	~ DRAWING 5 PAD DETAILS
761379-T9	~ TRANSFORMER PAD DETAILS
761379-T10	~ PRIMARY METERING PAD DETAILS
921767	~ 22559 CIRCUIT EXTENSION DRAWINGS

22559 EXTENSION ~ PWSA HIGHLAND PUMP BUNKERHILL ST, MELLON ST PITTSBURGH, 11TH WARD
OH CONSTRUCTION DRAWING 3

REVISIONS

APPROVED
By Michael F. Higgins at 2:50 pm, Mar 21, 2025



DLG DUQUESNE LIGHT COMPANY

AS-SUSSED CH'D	AS-MARKED CH'D	DRAWN BY F. OBAID	DATE 1/7/2025	ENCL. CHIL.	DATE
DATE	ENCL. CHIL.	DATE	FINAL APP. L. PERKS	DATE 1/10/2025	

22559 EXTENSION ~ PWSA HIGHLAND PUMP BUNKERHILL ST, MELLON ST PITTSBURGH, 11TH WARD				
OH CONSTRUCTION DRAWING 3				
ANSI D	SCALE N.T.S.	FRN NO. 20-0049	ORF. NO. 921767-T3	REV 1

FINAL DESIGN PA ONECALL
SERIAL NUMBERS
20242753768



SUMMARY		
DLC WORK	QTY	PRIVATE PROPERTY
INSTALL POLE	3	(1) (2) (11)
INSTALL ANCHOR	2	(1) (11)

761379-T2 ~ OH CONSTRUCTION DRAWING 2
761379-T3 ~ UG CONSTRUCTION DRAWING
761379-T4 ~ CABLE PULL DRAWING
761379-T5 ~ D23825 REMOVALS
761379-T6 ~ CIRCUIT MAP REVISION
761379-T7 ~ EQUIPMENT GROUNDING DETAILS
761379-T8 ~ DLM-5 PAD DETAILS
761379-T9 ~ TRANSFORMER PAD DETAILS
761379-T10 ~ PRIMARY METERING PAD DETAILS
921767 ~ 225959 CIRCUIT EXTENSION DRAWINGS


 DLG				PWSA HIGHLAND PARK PUMP ~ NEW BUSINESS 1500 N. NEGLEY AVE CITY OF PITTSBURGH, 11TH WARD			
AS-BUILT CWD		AS-BUILT CWD		DRAWN BY F. OBADI		DATE 12/9/2024	
				ENCL. CHK.		DATE	
DATE		ENCL. CHK.		DATE		FINAL APP.	
				L. PERKS		1/10/2025	
ANSL		SCALE		PPN NO.		DWG. NO.	
D		N.T.S.		20-0005		761379-T1	
						REV.	
						1	

No. 761379-T2



FINAL DESIGN PA ONECALL
SERIAL NUMBERS
761379-T2

MAP: F7-6
GIS: 4644
CKT: 22559
(HIGHLAND-EAST END NO. 4)

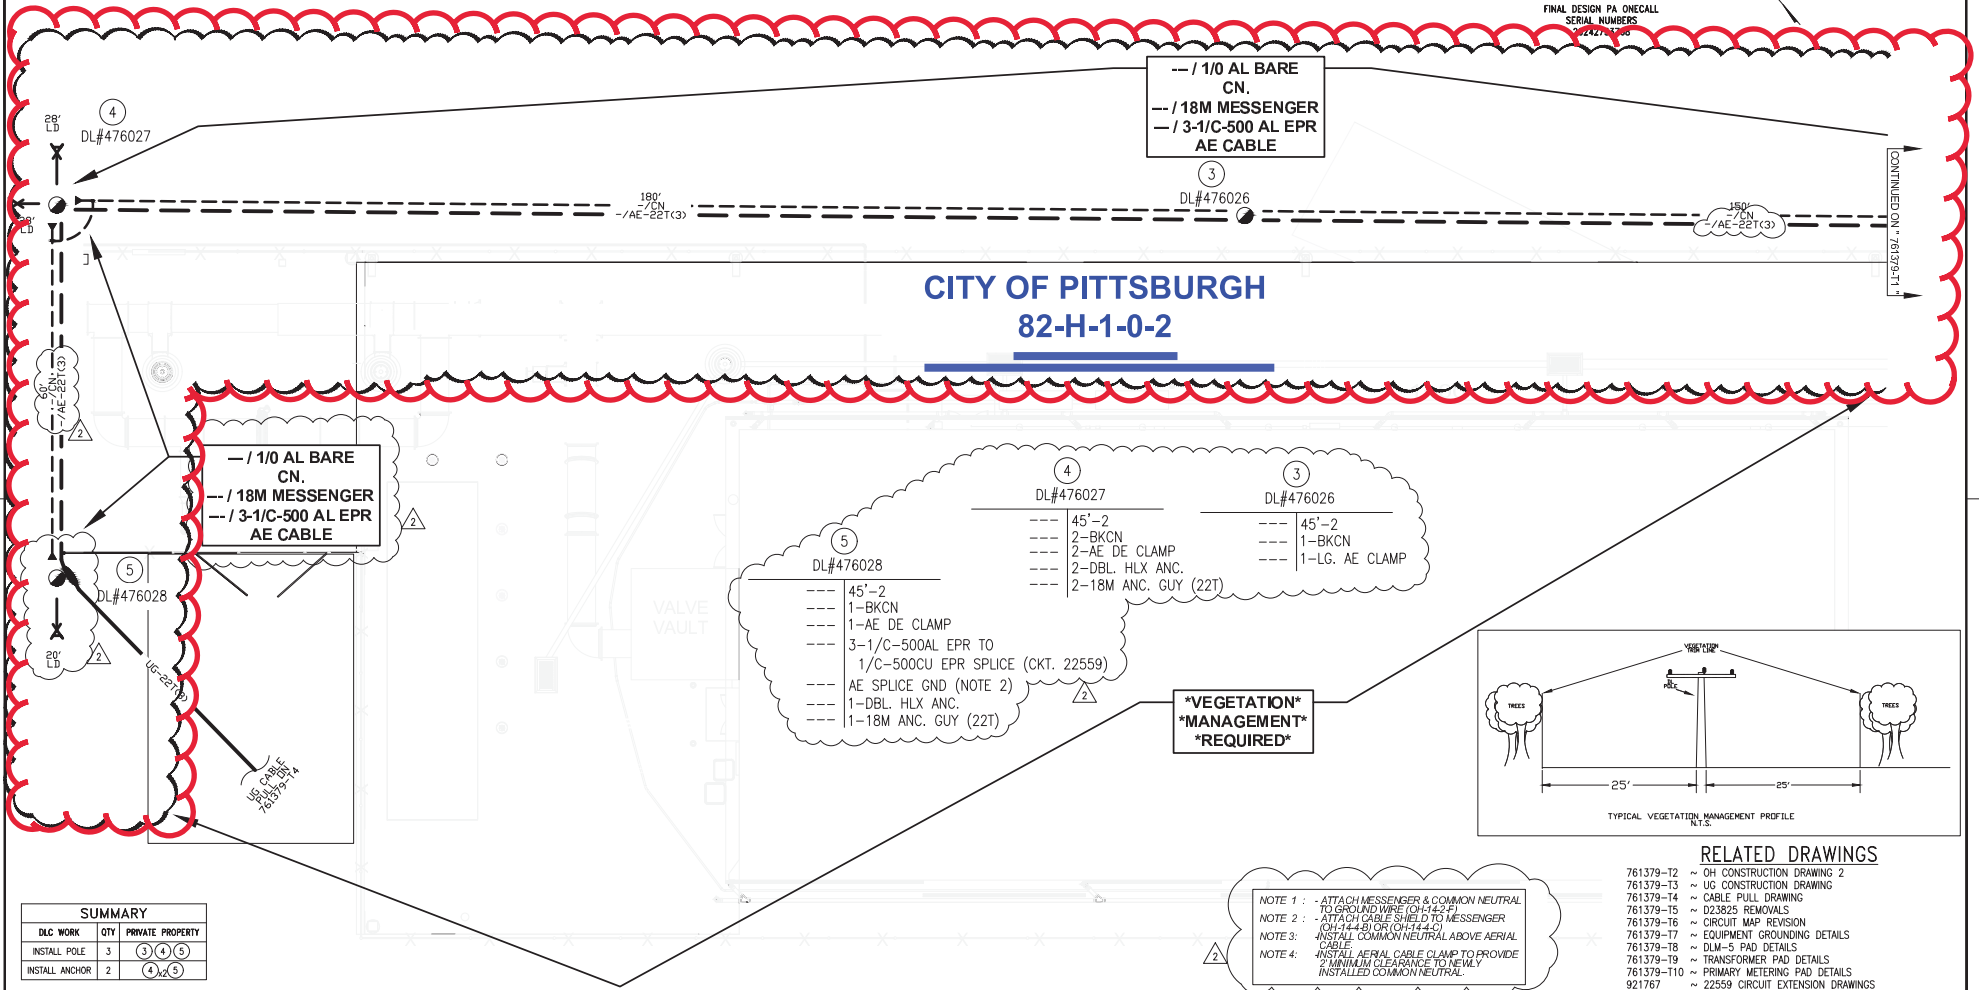

REVISIONS	DATE	BY	REASON
1	1/10/2025	F. OBAID	APPROVED
2	1/10/2025	L. PERKS	REVISION

APPROVED
By Michael F. Higgins at 2:45 pm, Mar 21, 2025

DLC DUQUESNE LIGHT CO.

DESIGNED	CHECKED	DATE	BY	DATE	BY
F. OBAID	L. PERKS	12/9/2024	1/10/2025		

PSWA HIGHLAND PARK PUMP ~ NEW BUSINESS 1500 N. NEGLY AVE CITY OF PITTSBURGH, 11TH WARD	OH CONSTRUCTION DRAWING 2
AND SCALE	N.T.S.
PROJECT NO.	20-0005
DRAWING NO.	761379-T2
REV.	2