



EXHIBIT A

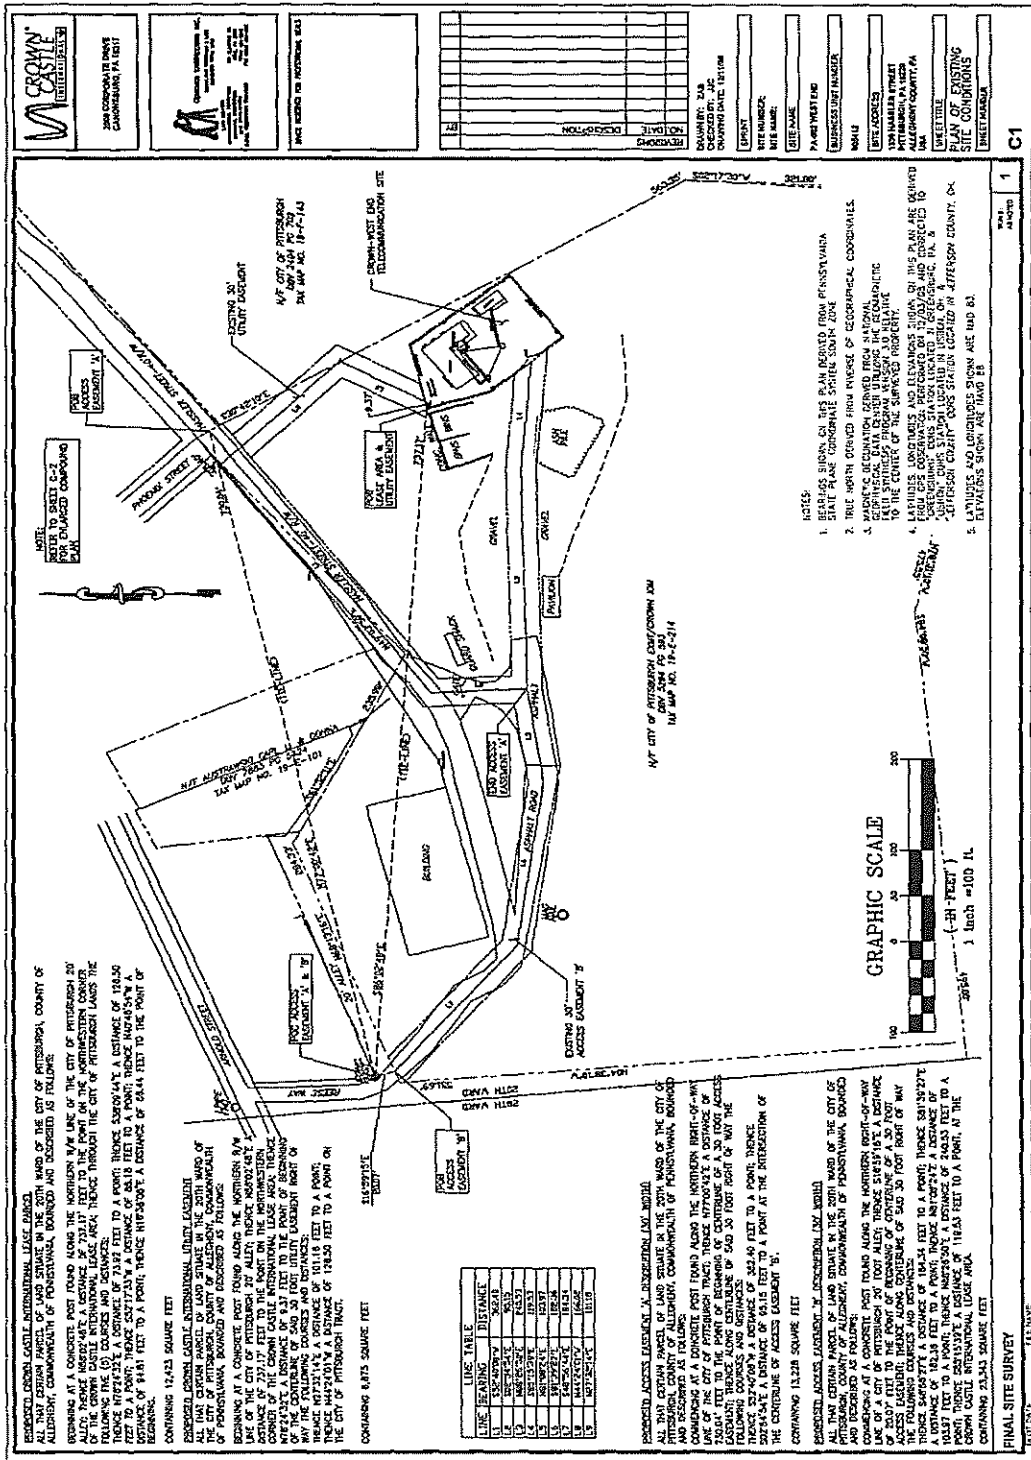

Site Name: PA 082 West End
 BU: 805412
 PPAB 6634370v1
 PPAB 10231769v3

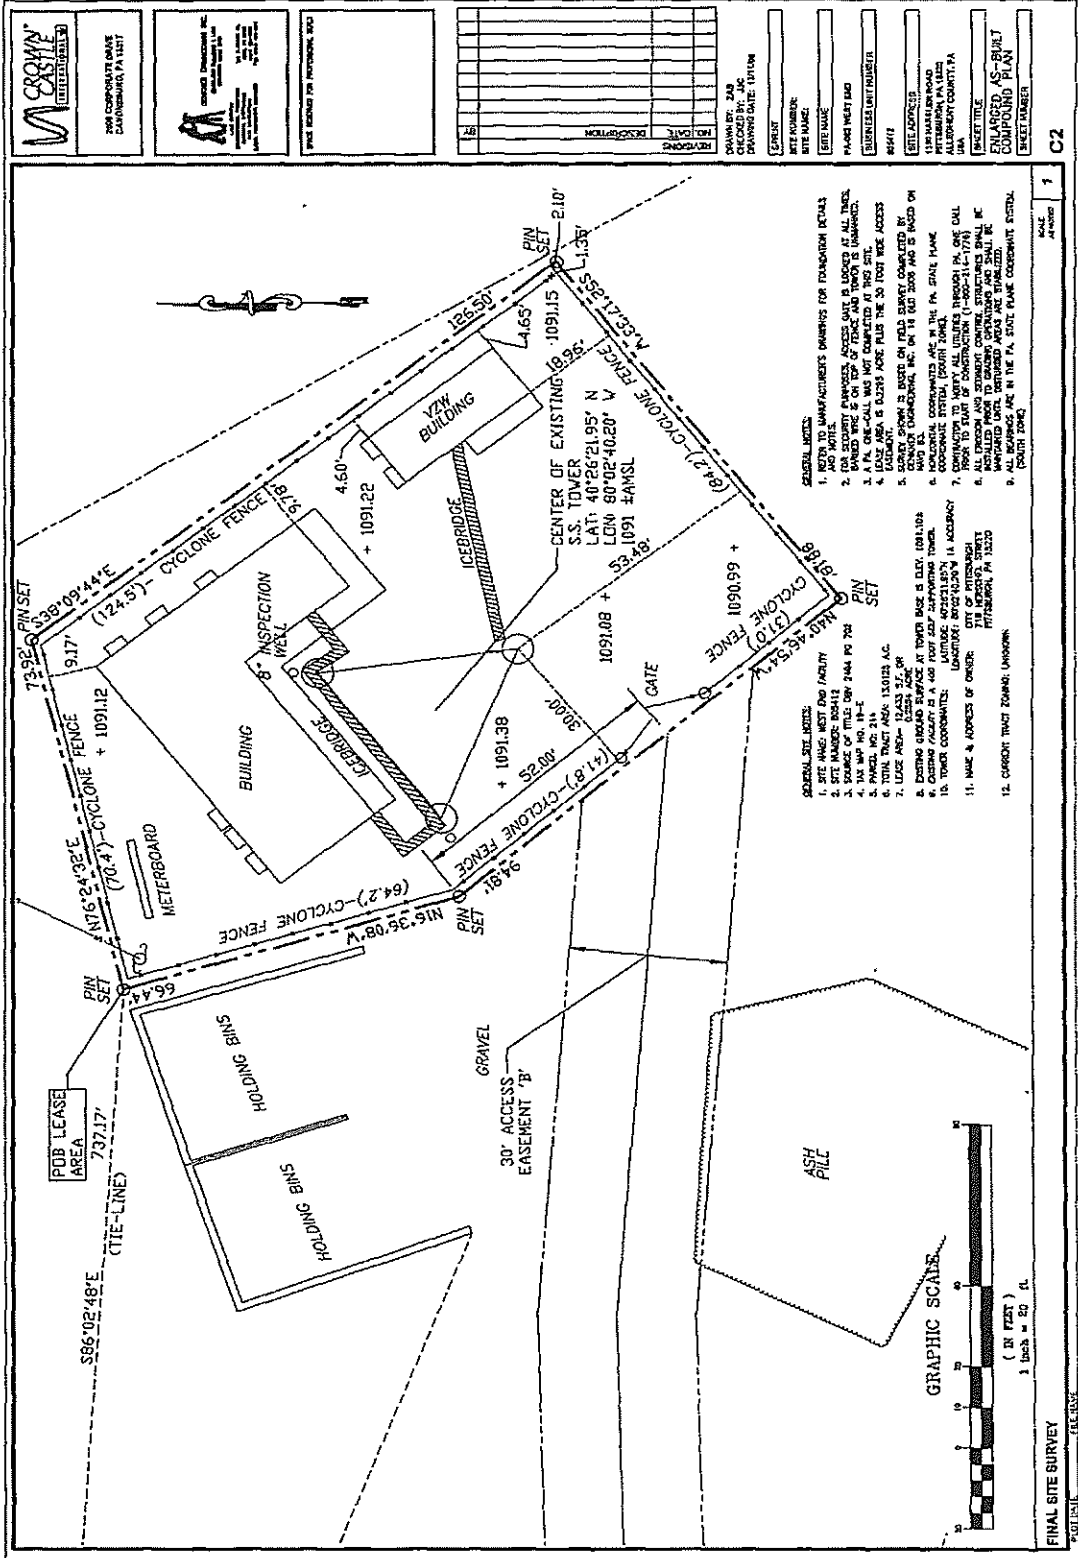

CROWN CASTLE
 200 CORPORATE BLVD
 CHARLESTON, VA 23017

CONCRETE
 1000 W. MARKET ST.
 PITTSBURGH, PA 15222

FIELD RECORD FOR PROJECT NO. 082
 DATE: 10/12/11

NO.	DATE	DESCRIPTION
1		
2		
3		
DRAWN BY: JAC
 CHECKED BY: JAC
 DRAWING DATE: 10/10/11

PROJECT NUMBER:
 SITE NAME:
 SITE VALUE:
 PLANNING DISTRICT:
 SURVEY UNIT NUMBER:
 86411


DATE ACQUIRED:
 10/10/11
 LOCATION:
 PITTSBURGH, PA 15222
 COUNTY:
 WASHINGTON COUNTY, PA

PROJECT TITLE:
 ENLARGED AS-BUILT
 COMPOUND PLAN

SHEET NUMBER:
 1

- GENERAL NOTES:**
1. ALL PROPERTY MANUFACTURER'S DIMENSIONS FOR FOUNDATION DETAILS AND ALL OTHER DIMENSIONS ARE TO FACE UNLESS OTHERWISE NOTED.
 2. FOR SECURITY PURPOSES, ACCESS GATE IS LOCKED AT ALL TIMES. GATE KEYS ARE ON THE PREMISES AND NOT TO BE LOANED.
 3. ALL DIMENSIONS ARE TO FACE UNLESS OTHERWISE NOTED.
 4. UTILITY AREA IS 50' TO 100' WIDE PLUS THE 30' TYPICAL ACCESS EASEMENT.
 5. CENTER OF EXISTING 10.9915' S.S. TOWER IS 40°26'21.95" N LAT. 80°02'40.20" W LONG. 80°02'40.20" W LONG. 80°02'40.20" W LONG. 80°02'40.20" W LONG.
 6. ALL DIMENSIONS ARE TO FACE UNLESS OTHERWISE NOTED.
 7. CONSTRUCTION TO VERIFY ALL UTILITIES (WATER, GAS, ELEC.) ARE DEPTH AND LOCATION AS SHOWN ON THIS PLAN. ALL UTILITIES SHALL BE MARKED AND DEPTH SHALL BE VERIFIED BY THE CONTRACTOR.
 8. ALL DIMENSIONS ARE TO FACE UNLESS OTHERWISE NOTED.
 9. ALL DIMENSIONS ARE TO FACE UNLESS OTHERWISE NOTED.

- GENERAL NOTES:**
1. SITE VALUE IS 1000.00 AC.
 2. SURFACE OF TILES ON 2404 PG 700.
 3. 3/4" W.P. NO. 14-E.
 4. 3/4" W.P. NO. 14-E.
 5. 3/4" W.P. NO. 14-E.
 6. 3/4" W.P. NO. 14-E.
 7. 3/4" W.P. NO. 14-E.
 8. 3/4" W.P. NO. 14-E.
 9. 3/4" W.P. NO. 14-E.
 10. 3/4" W.P. NO. 14-E.
 11. NAME & ADDRESS OF OWNER: 1000 W. MARKET ST., PITTSBURGH, PA 15222
 12. CURRENT TRACT ZONING: UNKNOWN

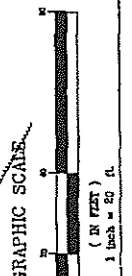

FINAL SITE SURVEY
 PROJECT NO. 082

Site Name: PA 082 West End
 BU: 805412
 PPAB 6634370v1
 PPAB 10231769v3