No.1045498-T1

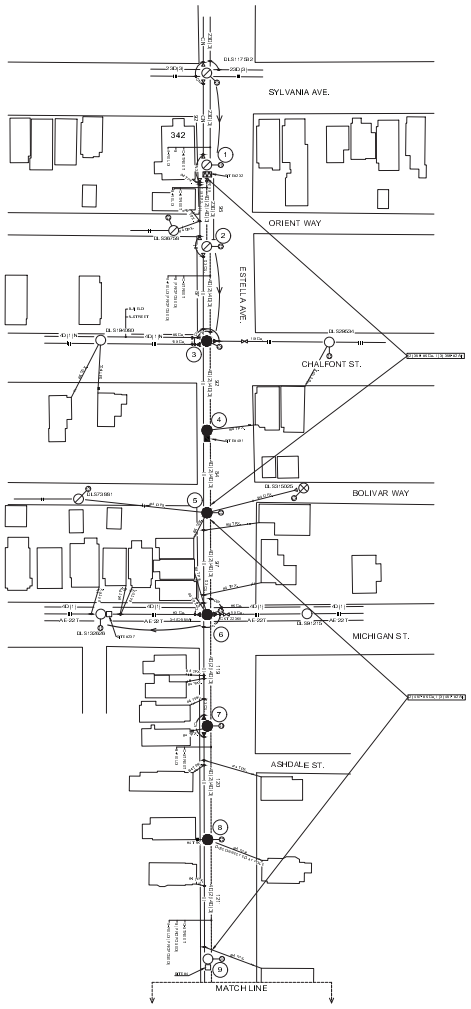

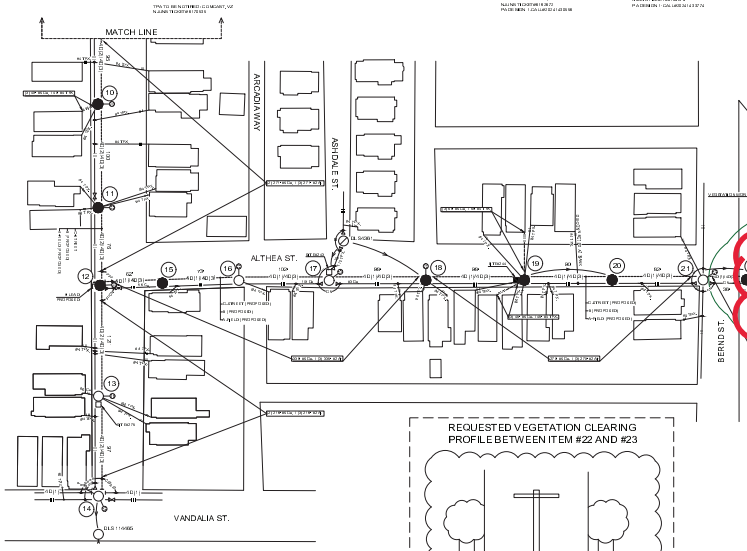

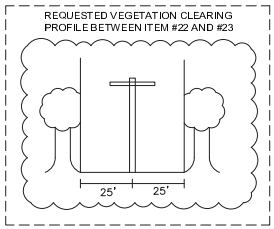

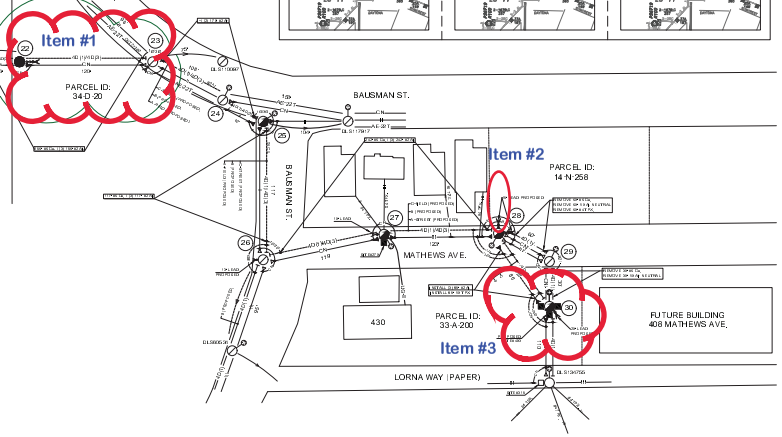

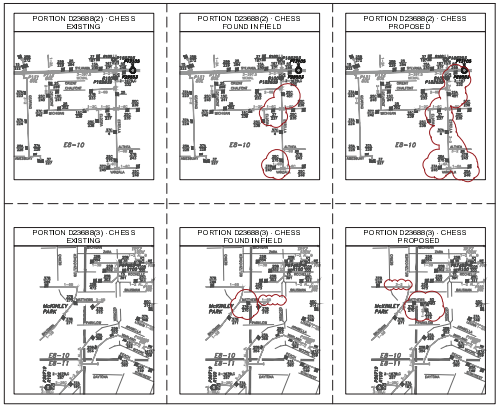

MAP E8-10
E8-14
CKT. D23688 (2/3)
CHESS

22360
CARRICK-CHESS

REVISIONS

ASBUILTED. CHK'D | AS MARKED. CHK'D | DATE | SCALE N.T.S.

DUQUESNE LIGHT CO.

SCALE N.T.S. | DRAFT BY N. POLLO | DATE 6/21/2024 | ENGR. CHK'D | DATE | DRAFT CHK'D | DATE

APPROVED
By zprawucki at 2:06 pm, Jun 28, 2024

THREE-PHASE EXTENSION CHESS D23688
408 MATHEWS AVE. PGH., 30th WARD
CONSTRUCTION PRINT

D | FPA NO. 20-0048 | DWG. NO. 1045498-T1 | REV. NO.